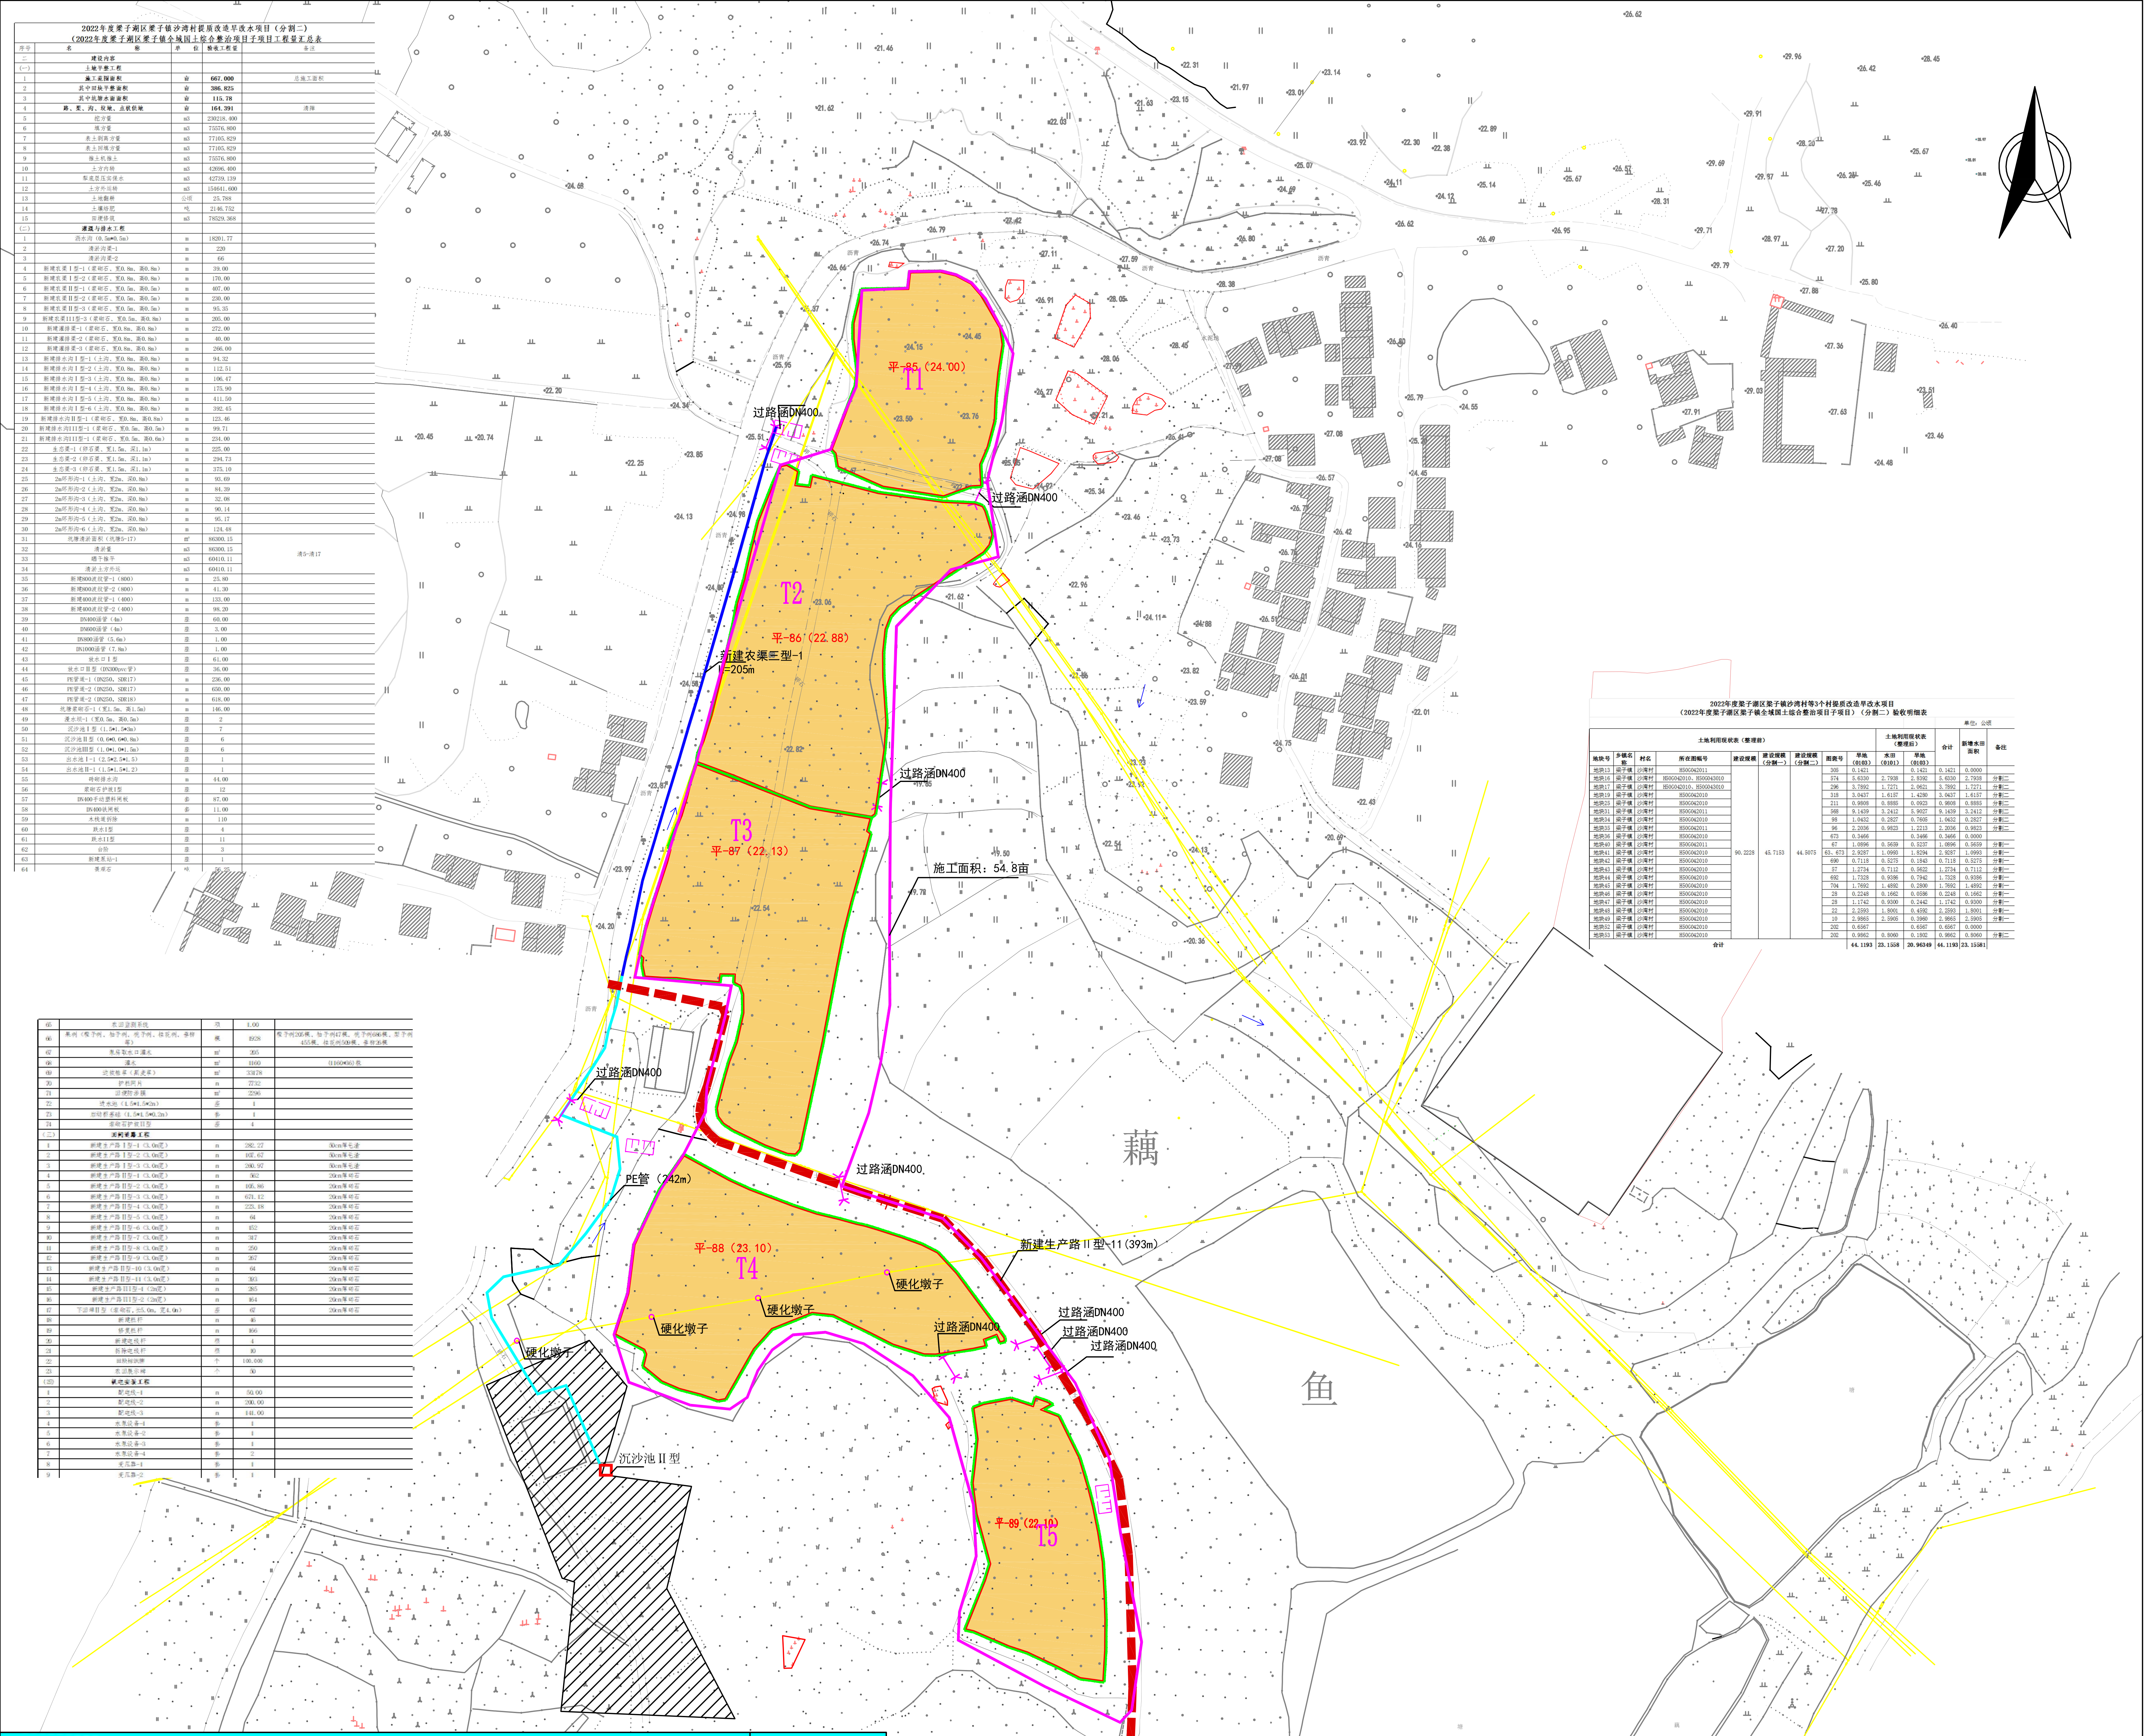

2022年度梁子湖区梁子镇沙湾村提质改造旱改水项目（分割二）
（2022年度梁子湖区梁子镇全域国土综合整治项目子项目工程量汇总表

序号	名称	单位	验收工程量	备注
二	建设内容			
(一)	土地平整工程			
1	施工范围面积	亩	667.000	总施工面积
2	其中田块平整面积	亩	386.825	
3	其中坑塘水面面积	亩	115.78	
4	路、渠、沟、坟地、点状供地	亩	164.391	清障
5	挖方量	m3	230218.400	
6	填方量	m3	75576.800	
7	表土剥离方量	m3	77105.829	
8	表土回填方量	m3	77105.829	
9	推土机推土	m3	75576.800	
10	土方内转	m3	42696.400	
11	犁底层压实保水	m3	42739.139	
12	土方外运转	m3	154641.600	
13	土地翻耕	公顷	25.788	
14	土壤培肥	吨	2146.752	
15	田埂修筑	m3	78529.368	
(二)	灌溉与排水工程			
1	沥水沟（0.5m*0.5m）	m	18201.77	
2	清淤沟渠-1	m	220	
3	清淤沟渠-2	m	66	
4	新建农渠Ⅰ型-1（浆砌石、宽0.8m、高0.8m）	m	39.00	
5	新建农渠Ⅰ型-2（浆砌石、宽0.8m、高0.8m）	m	170.00	
6	新建农渠Ⅱ型-1（浆砌石、宽0.5m、高0.5m）	m	407.00	
7	新建农渠Ⅱ型-2（浆砌石、宽0.5m、高0.5m）	m	230.00	
8	新建农渠Ⅱ型-3（浆砌石、宽0.5m、高0.5m）	m	95.35	
9	新建农渠III型-3（浆砌石、宽0.5m、高0.8m）	m	205.00	
10	新建灌排渠-1（浆砌石、宽0.8m、高0.8m）	m	272.00	
11	新建灌排渠-2（浆砌石、宽0.8m、高0.8m）	m	40.00	
12	新建灌排渠-3（浆砌石、宽0.8m、高0.8m）	m	266.00	
13	新建排水沟Ⅰ型-1（土沟、宽0.8m、高0.8m）	m	94.32	
14	新建排水沟Ⅰ型-2（土沟、宽0.8m、高0.8m）	m	112.51	
15	新建排水沟Ⅰ型-3（土沟、宽0.8m、高0.8m）	m	106.47	
16	新建排水沟Ⅰ型-4（土沟、宽0.8m、高0.8m）	m	175.90	
17	新建排水沟Ⅰ型-5（土沟、宽0.8m、高0.8m）	m	411.50	
18	新建排水沟Ⅰ型-6（土沟、宽0.8m、高0.8m）	m	392.45	
19	新建排水沟Ⅱ型-1（浆砌石、宽0.8m、高0.8m）	m	123.46	
20	新建排水沟III型-1（浆砌石、宽0.5m、高0.5m）	m	99.71	
21	新建排水沟III型-1（浆砌石、宽0.5m、高0.6m）	m	234.00	
22	生态渠-1（卵石渠、宽1.5m、深1.1m）	m	225.00	
23	生态渠-2（卵石渠、宽1.5m、深1.1m）	m	294.73	
24	生态渠-3（卵石渠、宽1.5m、深1.1m）	m	375.10	
25	2m环形沟-1（土沟、宽2m、深0.8m）	m	93.69	
26	2m环形沟-2（土沟、宽2m、深0.8m）	m	84.39	
27	2m环形沟-3（土沟、宽2m、深0.8m）	m	32.08	
28	2m环形沟-4（土沟、宽2m、深0.8m）	m	90.14	
29	2m环形沟-5（土沟、宽2m、深0.8m）	m	95.17	
30	2m环形沟-6（土沟、宽2m、深0.8m）	m	124.48	
31	坑塘清淤面积（坑塘5-17）	m²	86300.15	清5-清17
32	清淤量	m3	86300.15	
33	晒干推平	m3	60410.11	
34	清淤土方外运	m3	60410.11	
35	新建800波纹管-1（800）	m	25.80	
36	新建800波纹管-2（800）	m	41.30	
37	新建400波纹管-1（400）	m	133.00	
38	新建400波纹管-2（400）	m	98.20	
39	DN400涵管（4m）	座	60.00	
40	DN600涵管（4m）	座	3.00	
41	DN800涵管（5.6m）	座	1.00	
42	DN1000涵管（7.8m）	座	1.00	
43	放水口Ⅰ型	座	61.00	
44	放水口Ⅱ型（DN300pvc管）	座	36.00	
45	PE管道-1（DN250，SDR17）	m	236.00	
46	PE管道-2（DN250，SDR17）	m	650.00	
47	PE管道-2（DN250，SDR18）	m	618.00	
48	坑塘浆砌石-1（宽1.5m、高1.5m）	m	146.00	
49	漫水坝-1（宽0.5m、高0.5m）	座	2	
50	沉沙池Ⅰ型（1.5*1.5*3m）	座	7	
51	沉沙池Ⅱ型（0.6*0.6*0.8m）	座	6	
52	沉沙池Ⅲ型（1.0*1.0*1.5m）	座	6	
53	出水池Ⅰ-1（2.5*2.5*1.5）	座	1	
54	出水池Ⅱ-1（1.5*1.5*1.2）	座	1	
55	砖砌排水沟	m	44.00	
56	浆砌石护坡I型	座	12	
57	DN400手动塑料闸板	套	87.00	
58	DN400铁闸板	套	11.00	
59	木栈道拆除	m	110	
60	跌水I型	座	4	
61	跌水II型	座	11	
62	台阶	座	3	
63	新建泵站-1	座	1	
64	景观石	吨	56.25	
65	农田监测系统	项	1.00	
66	果树（橘子树、柚子树、桃子树、桂花树、香榧等）	棵	1928	橘子树205棵、柚子树47棵、桃子树686棵、梨子树455棵、桂花树509棵、香榧26棵
67	泵房取水口灌木	m²	205	
68	灌木	m²	1160	(1160*36)株
69	边坡植草（黑麦草）	m²	33178	
70	护栏网片	m	7732	
71	田埂防渗膜	m²	2296	
72	进水池（1.5*1.5*2m）	座	1	
73	启动柜基础（1.5*1.5*0.2m）	套	1	
74	浆砌石护坡II型	座	4	
(三)	田间道路工程			
1	新建生产路Ⅰ型-1（3.0m宽）	m	282.27	50cm厚毛渣
2	新建生产路Ⅰ型-2（3.0m宽）	m	107.67	50cm厚毛渣
3	新建生产路Ⅰ型-3（3.0m宽）	m	260.97	50cm厚毛渣
4	新建生产路Ⅱ型-1（3.0m宽）	m	562	20cm厚碎石
5	新建生产路Ⅱ型-2（3.0m宽）	m	105.86	20cm厚碎石
6	新建生产路Ⅱ型-3（3.0m宽）	m	671.12	20cm厚碎石
7	新建生产路Ⅱ型-4（3.0m宽）	m	223.18	20cm厚碎石
8	新建生产路Ⅱ型-5（3.0m宽）	m	64	20cm厚碎石
9	新建生产路Ⅱ型-6（3.0m宽）	m	152	20cm厚碎石
10	新建生产路Ⅱ型-7（3.0m宽）	m	317	20cm厚碎石
11	新建生产路Ⅱ型-8（3.0m宽）	m	250	20cm厚碎石
12	新建生产路Ⅱ型-9（3.0m宽）	m	267	20cm厚碎石
13	新建生产路Ⅱ型-10（3.0m宽）	m	64	20cm厚碎石
14	新建生产路Ⅱ型-11（3.0m宽）	m	393	20cm厚碎石
15	新建生产路III型-1（2m宽）	m	285	20cm厚碎石
16	新建生产路III型-2（2m宽）	m	164	20cm厚碎石
17	下田坡Ⅱ型（浆砌石，长5.0m，宽4.0m）	座	67	20cm厚碎石
18	新建栏杆	m	46	
19	修复栏杆	m	166	
20	新建电线杆	根	4	
21	拆除电线杆	根	10	
22	田块标识牌	个	100.000	
23	农田展示牌	个	50	
(四)	机电安装工程			
1	配电线-1	m	50.00	
2	配电线-2	m	200.00	
3	配电线-3	m	141.00	
4	水泵设备-1	套	1	
5	水泵设备-2	套	1	
6	水泵设备-3	套	1	
7	水泵设备-4	套	2	
8	变压器-1	套	1	
9	变压器-2	套	1	

2022年度梁子湖区梁子镇沙湾村等3个村提质改造旱改水项目
（2022年度梁子湖区梁子镇全域国土综合整治项目子项目）（分割二）验收明细表

单位：公顷

土地利用现状表（整理前）									土地利用现状表（整理后）		合计	新增水田面积	备注
地块号	乡镇名称	村名	所在图幅号	建设规模	建设规模（分割一）	建设规模（分割二）	图斑号	旱地（0103）	水田（0101）	旱地（0103）			
地块13	梁子镇	沙湾村	H50G042011	90.2228	45.7153	44.5075	305	0.1421		0.1421	0.1421	0.0000	
地块16	梁子镇	沙湾村	H50G042010、H50G043010				574	5.6330	2.7938	2.8392	5.6330	2.7938	分割二
地块17	梁子镇	沙湾村	H50G042010、H50G043010				296	3.7892	1.7271	2.0621	3.7892	1.7271	分割二
地块19	梁子镇	沙湾村	H50G042010				318	3.0437	1.6157	1.4280	3.0437	1.6157	分割二
地块25	梁子镇	沙湾村	H50G042010				211	0.9808	0.8885	0.0923	0.9808	0.8885	分割二
地块31	梁子镇	沙湾村	H50G042011				568	9.1439	3.2412	5.9027	9.1439	3.2412	分割二
地块34	梁子镇	沙湾村	H50G042010				98	1.0432	0.2827	0.7605	1.0432	0.2827	分割二
地块35	梁子镇	沙湾村	H50G042011				96	2.2036	0.9823	1.2213	2.2036	0.9823	分割二
地块36	梁子镇	沙湾村	H50G042010				673	0.3466		0.3466	0.3466	0.0000	
地块40	梁子镇	沙湾村	H50G042011				67	1.0896	0.5659	0.5237	1.0896	0.5659	分割一
地块41	梁子镇	沙湾村	H50G042010				63、673	2.9287	1.0993	1.8294	2.9287	1.0993	分割一
地块42	梁子镇	沙湾村	H50G042010				690	0.7118	0.5275	0.1843	0.7118	0.5275	分割一
地块43	梁子镇	沙湾村	H50G042010				57	1.2734	0.7112	0.5622	1.2734	0.7112	分割一
地块44	梁子镇	沙湾村	H50G042010				692	1.7328	0.9386	0.7942	1.7328	0.9386	分割一
地块45	梁子镇	沙湾村	H50G042010				704	1.7692	1.4892	0.2800	1.7692	1.4892	分割一
地块46	梁子镇	沙湾村	H50G042010				28	0.2248	0.1662	0.0586	0.2248	0.1662	分割一
地块47	梁子镇	沙湾村	H50G042010				28	1.1742	0.9300	0.2442	1.1742	0.9300	分割一
地块48	梁子镇	沙湾村	H50G042010				22	2.2593	1.8001	0.4592	2.2593	1.8001	分割一
地块49	梁子镇	沙湾村	H50G042010				10	2.9865	2.5905	0.3960	2.9865	2.5905	分割一
地块52	梁子镇	沙湾村	H50G042010				202	0.6567		0.6567	0.6567	0.0000	
地块53	梁子镇	沙湾村	H50G042010				202	0.9862	0.8060	0.1802	0.9862	0.8060	分割二
合计								44.1193	23.1558	20.96349	44.1193	23.15581	

2022年度梁子湖区梁子镇沙湾村提质改造旱改水项目（分割二）
（2022年度梁子湖区梁子镇全域国土综合整治项目子项目）竣工图

竣工测量单位	北京跨时空国土规划设计院有限公司		
审定	卢战雷	测图比例尺	1:1000
校核	陈志木	打印比例尺	1:4000
测量	范建	制图日期	2026.6
制图	范建	图号	